

Gross External Area
111.10 m2


Gross Internal Area
100.00 m2


142 OXSTALLS WAY

GARDEN

OXSTALLS WAY

SERVICE ROAD

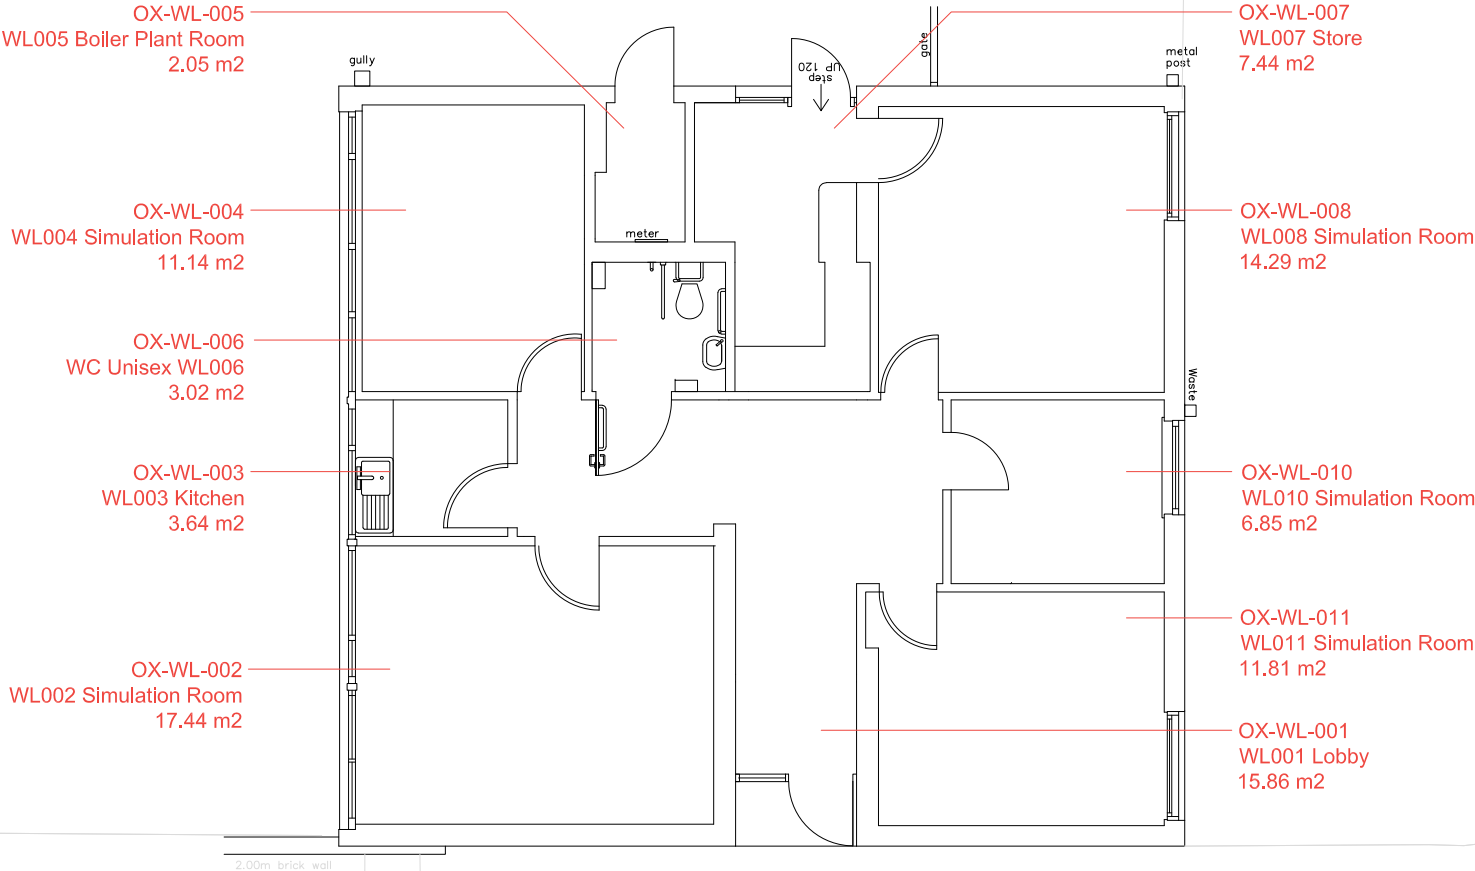

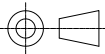3rd Angle Projection U.N.O. 

Do not scale this print.

Notes

Rev	Comment	By	Date
-----	---------	----	------

 **UNIVERSITY OF
GLOUCESTERSHIRE**

Dunholme Villa
The Park Campus
The Park
Cheltenham
GL50 2RH
t: 01242 714888

Drawing Status
As Built

Campus Location
**Oxstalls
Gloucester GL2 9HW**

Drawing Title
**Willow Lodge
Ground Floor
Floor Plan**

Scale	Drawn	Check	Rev.
1:100 @ A3	SW		03

Date
06-12-2021

Drawing Number
OX-WL-0-FP